

Order ~~LATE~~ * Rush *

Ship Aug 11

Work Order ID 135090

Tuesday, July 28, 2015 3:46:11 PM

646.3015
B135090
REV. N/C

135090

Item ID: 646.3015

Revision ID:

Item Name: Blade

Start Date: 7/28/15

Start Qty: 12.00

12

Required Date: 8/12/15

Req'd Qty: 12.00

12

Reference:

Approvals:

Process Plan: 

Date: 15.7.28

Tooling:

Date:

QC:

Date:

SPC (Y/N):

Date:

Run

Start

NR1

Stop

NR2

Sequence ID/ Work Center ID	Operation Description	Set Up/ Run Hours	Tool ID	Tool #	Plan Code	Accept Qty	Reject Qty	Reject Number	Insp. Stamp
--------------------------------	--------------------------	----------------------	---------	--------	--------------	---------------	---------------	------------------	----------------

Draw Nbr	Revision Nbr
646.3000	N/C

100

100

Bandsaw
Jeaspa Bandsaw

BAND SAW

Memo

Cut Blank at 6.580"

0.00

0.00

12 ~~0~~

DAS
20
9-89 15-08-11

110

110

HAAS 1
HAAS CNC vertical machine #1

HAAS CNC VERTICAL MACHINING #1

Memo

1-Machine per folio FB150
DWG REV: N/C
FOLIO REV: AA

0.00

0.00

12 ~~0~~

DAS
20
9-89 15-08-12

2- deburr and break all sharp edges except otherwise noted

KNIFE EDGE MUST BE SHARPENED USING STONE, REMOVE ALL
BURRS ON CUTTING EDGE

DQA: _____ Date: _____



WORK ORDER NON-CONFORMANCE / UPDATE

QA Closed: _____ Date: _____

Work Order update only ☐

Work Order: _____ Part No. _____ NCR No. _____		DISPOSITION Rework ☐ Scrap ☐ Use-as-is ☐ Suspected Unapproved ☐		AGAINST DEPARTMENT/PROCESS <table style="width:100%; border: none;"> <tr> <td style="width:12.5%;">Skid-tube ☐</td> <td style="width:12.5%;">Cross tube ☐</td> <td style="width:12.5%;">Water Jet ☐</td> <td style="width:12.5%;">Engineering ☐</td> </tr> <tr> <td>Machining ☐</td> <td>Small Fab ☐</td> <td>Prod. Eng. Coord. ☐</td> <td>Quality ☐</td> </tr> <tr> <td>Thermoforming ☐</td> <td>Finishing ☐</td> <td>Rec/Store/Packaging ☐</td> <td>Other ☐</td> </tr> <tr> <td>Large Fab ☐</td> <td>Composite ☐</td> <td>Supplier ☐</td> <td></td> </tr> </table>						Skid-tube ☐	Cross tube ☐	Water Jet ☐	Engineering ☐	Machining ☐	Small Fab ☐	Prod. Eng. Coord. ☐	Quality ☐	Thermoforming ☐	Finishing ☐	Rec/Store/Packaging ☐	Other ☐	Large Fab ☐	Composite ☐	Supplier ☐	
Skid-tube ☐	Cross tube ☐	Water Jet ☐	Engineering ☐	
Machining ☐	Small Fab ☐	Prod. Eng. Coord. ☐	Quality ☐	
Thermoforming ☐	Finishing ☐	Rec/Store/Packaging ☐	Other ☐	
Large Fab ☐	Composite ☐	Supplier ☐	
Date :		Step #:		QTY Effective :			MRB (QS1042) Approval	
Description Work Order Deviation				Disposition				Completed By	
								Lead hand / Supervisor Approval Verification	
								QC / QA Coordinator Approval	
Root Cause <table style="width:100%; border: none;"> <tr> <td style="width:12.5%;">Environment ☐</td> <td style="width:12.5%;">No Re-verification ☐</td> <td style="width:12.5%;">Pressure/Forced ☐</td> <td style="width:12.5%;">Temperature/Cure ☐</td> <td style="width:12.5%;">Power Loss/Surge ☐</td> <td style="width:12.5%;">Positioned Wrong ☐</td> </tr> <tr> <td>Design ☐</td> <td>Operator ☐</td> <td>Bending ☐</td> <td>Set-up ☐</td> <td>Folio/Program ☐</td> <td>Outside Dimensions ☐</td> </tr> <tr> <td>Doc/Data ☐</td> <td>Offset/Setup ☐</td> <td>Centre Not Concentric ☐</td> <td>BOM/Route ☐</td> <td>Grain ☐</td> <td>Over/Under tolerance ☐</td> </tr> <tr> <td>Equip/Tooling ☐</td> <td>Supplier ☐</td> <td>Cracks ☐</td> <td>Broken/Damage/Defect ☐</td> <td>Weld ☐</td> <td>Part Incorrect ☐</td> </tr> <tr> <td>Handling/Pre ☐</td> <td>Training ☐</td> <td>Crimp/Kink/Ripple/Wave ☐</td> <td>Inspection Incomplete/Unqualified ☐</td> <td>Wrong Stock Pulled ☐</td> <td>Part Lost/Missing ☐</td> </tr> <tr> <td>Material ☐</td> <td>Use for Testing ☐</td> <td>Cuffs ☐</td> <td>Contamination ☐</td> <td>Out of Sequence ☐</td> <td>Part Moved ☐</td> </tr> <tr> <td>Internal Transport ☐</td> <td>Poor Information ☐</td> <td>Crushing ☐</td> <td>Countersink ☐</td> <td>Off-set ☐</td> <td>Drawing ☐</td> </tr> <tr> <td>Tribal Knowledge ☐</td> <td>Rushing ☐</td> <td>Heat Treat ☐</td> <td>Cut Too Short ☐</td> <td>Mislabeled ☐</td> <td>Finish ☐</td> </tr> <tr> <td>LOA ☐</td> <td>Product Improvement ☐</td> <td>Wave/Twist in Tube ☐</td> <td>Instructions Incomplete/Unclear ☐</td> <td>Fit/Function ☐</td> <td>Misread ☐</td> </tr> <tr> <td>Substation ☐</td> <td>Process Improvement ☐</td> <td>Marks/Chatter ☐</td> <td>Drill Holes ☐</td> <td>Misaligned/off center ☐</td> <td>Turning Sequence ☐</td> </tr> <tr> <td>Past Expiry Date ☐</td> <td>Manufacturing Process ☐</td> <td colspan="4"></td> </tr> <tr> <td>Misidentified ☐</td> <td>Past Due ☐</td> <td colspan="4"></td> </tr> </table>				Environment ☐	No Re-verification ☐	Pressure/Forced ☐	Temperature/Cure ☐	Power Loss/Surge ☐	Positioned Wrong ☐	Design ☐	Operator ☐	Bending ☐	Set-up ☐	Folio/Program ☐	Outside Dimensions ☐	Doc/Data ☐	Offset/Setup ☐	Centre Not Concentric ☐	BOM/Route ☐	Grain ☐	Over/Under tolerance ☐	Equip/Tooling ☐	Supplier ☐	Cracks ☐	Broken/Damage/Defect ☐	Weld ☐	Part Incorrect ☐	Handling/Pre ☐	Training ☐	Crimp/Kink/Ripple/Wave ☐	Inspection Incomplete/Unqualified ☐	Wrong Stock Pulled ☐	Part Lost/Missing ☐	Material ☐	Use for Testing ☐	Cuffs ☐	Contamination ☐	Out of Sequence ☐	Part Moved ☐	Internal Transport ☐	Poor Information ☐	Crushing ☐	Countersink ☐	Off-set ☐	Drawing ☐	Tribal Knowledge ☐	Rushing ☐	Heat Treat ☐	Cut Too Short ☐	Mislabeled ☐	Finish ☐	LOA ☐	Product Improvement ☐	Wave/Twist in Tube ☐	Instructions Incomplete/Unclear ☐	Fit/Function ☐	Misread ☐	Substation ☐	Process Improvement ☐	Marks/Chatter ☐	Drill Holes ☐	Misaligned/off center ☐	Turning Sequence ☐	Past Expiry Date ☐	Manufacturing Process ☐					Misidentified ☐	Past Due ☐					FAULT CATEGORY OTHER : _____			
Environment ☐	No Re-verification ☐	Pressure/Forced ☐	Temperature/Cure ☐	Power Loss/Surge ☐	Positioned Wrong ☐	
Design ☐	Operator ☐	Bending ☐	Set-up ☐	Folio/Program ☐	Outside Dimensions ☐	
Doc/Data ☐	Offset/Setup ☐	Centre Not Concentric ☐	BOM/Route ☐	Grain ☐	Over/Under tolerance ☐	
Equip/Tooling ☐	Supplier ☐	Cracks ☐	Broken/Damage/Defect ☐	Weld ☐	Part Incorrect ☐	
Handling/Pre ☐	Training ☐	Crimp/Kink/Ripple/Wave ☐	Inspection Incomplete/Unqualified ☐	Wrong Stock Pulled ☐	Part Lost/Missing ☐	
Material ☐	Use for Testing ☐	Cuffs ☐	Contamination ☐	Out of Sequence ☐	Part Moved ☐	
Internal Transport ☐	Poor Information ☐	Crushing ☐	Countersink ☐	Off-set ☐	Drawing ☐	
Tribal Knowledge ☐	Rushing ☐	Heat Treat ☐	Cut Too Short ☐	Mislabeled ☐	Finish ☐	
LOA ☐	Product Improvement ☐	Wave/Twist in Tube ☐	Instructions Incomplete/Unclear ☐	Fit/Function ☐	Misread ☐	
Substation ☐	Process Improvement ☐	Marks/Chatter ☐	Drill Holes ☐	Misaligned/off center ☐	Turning Sequence ☐	
Past Expiry Date ☐	Manufacturing Process ☐	
Misidentified ☐	Past Due ☐	

DQA: _____ Date: _____



WORK ORDER NON-CONFORMANCE / UPDATE

QA Closed: _____ Date: _____

Work Order update only ☐

Work Order: _____ Part No. _____ NCR No. _____		DISPOSITION Rework ☐ Scrap ☐ Use-as-is ☐ Suspected Unapproved ☐		AGAINST DEPARTMENT/PROCESS Skid-tube ☐ Machining ☐ Thermoforming ☐ Large Fab ☐ Cross tube ☐ Small Fab ☐ Finishing ☐ Composite ☐ Water Jet ☐ Prod. Eng. Coord. ☐ Rec/Store/Packaging ☐ Supplier ☐ Engineering ☐ Quality ☐ Other ☐					
Date :		Step #:		QTY Effective :			MRB (QS1042) Approval Completed By Lead hand / Supervisor Approval Verification QC / QA Coordinator Approval		
Description Work Order Deviation				Disposition					
Root Cause Environment ☐ Design ☐ Doc/Data ☐ Equip/Tooling ☐ Handling/Pre ☐ Material ☐ Internal Transport ☐ Tribal Knowledge ☐ LOA ☐ Substation ☐ Past Expiry Date ☐ Misidentified ☐ No Re-verification ☐ Operator ☐ Offset/Setup ☐ Supplier ☐ Training ☐ Use for Testing ☐ Poor Information ☐ Rushing ☐ Product Improvement ☐ Process Improvement ☐ Manufacturing Process ☐ Past Due ☐		Pressure/Forced ☐ Bending ☐ Centre Not Concentric ☐ Cracks ☐ Crimp/Kink/Ripple/Wave ☐ Cuffs ☐ Crushing ☐ Heat Treat ☐ Wave/Twist in Tube ☐ Marks/Chatter ☐		FAULT CATEGORY Temperature/Cure ☐ Set-up ☐ BOM/Route ☐ Broken/Damage/Defect ☐ Inspection Incomplete/Unqualified ☐ Contamination ☐ Countersink ☐ Cut Too Short ☐ Instructions Incomplete/Unclear ☐ Drill Holes ☐ Power Loss/Surge ☐ Folio/Program ☐ Grain ☐ Weld ☐ Wrong Stock Pulled ☐ Out of Sequence ☐ Off-set ☐ Mislabeled ☐ Fit/Function ☐ Misaligned/off center ☐		Positioned Wrong ☐ Outside Dimensions ☐ Over/Under tolerance ☐ Part Incorrect ☐ Part Lost/Missing ☐ Part Moved ☐ Drawing ☐ Finish ☐ Misread ☐ Turning Sequence ☐			
		OTHER : _____							

Work Order ID 135090

135090

Page 3

Tuesday, July 28, 2015 3:46:11 PM

Item ID: 646.3015 Accept ***N900040100*** Setup Start ***NS1***
 Revision ID: Stop ***NS2***
 Item Name: Blade
 Start Date: 7/28/15 Start Qty: 12.00 ***12*** Cust Item ID:
 Required Date: 8/12/15 Req'd Qty: 12.00 ***12*** Customer:
 Reference:

Approvals: Process Plan: _____ Date: _____ Tooling: _____ Date: _____ Run Start ***NR1***
 QC: _____ Date: _____ SPC (Y/N): _____ Date: _____ Stop ***NR2***

Sequence ID/ Work Center ID	Operation Description	Set Up/ Run Hours	Tool ID	Tool #	Plan Code	Accept Qty	Reject Qty	Reject Number	Insp. Stamp
150	Receive & Inspect for Damage & Mat'l Certs	0.00				DAS 6 9-89			
150									
Packaging	Memo	0.00							
Packaging									
155	QC5- Inspect part completeness to step on W/O	0.00						DAS 38 9-89	
155									
QC	Memo	0.00							
Quality Control									
160	Spray Painting per QSI005 4.2	0.00						DAS 41 9-89	
160									
SprayPaint	Memo	0.00							
Spray Painting	PRIME AS PER DWG, SEE NOTE #4								
	PRIMER BATCH: <u>131277</u>								

(12)

AUG 28 2015

15-8-28

DQA: _____ Date: _____



WORK ORDER NON-CONFORMANCE / UPDATE

QA Closed: _____ Date: _____

Work Order update only ☐

Work Order: _____ Part No. _____ NCR No. _____	DISPOSITION Rework ☐ Scrap ☐ Use-as-is ☐ Suspected Unapproved ☐	AGAINST DEPARTMENT/PROCESS Skid-tube ☐ Machining ☐ Thermoforming ☐ Large Fab ☐ Cross tube ☐ Small Fab ☐ Finishing ☐ Composite ☐ Water Jet ☐ Prod. Eng. Coord. ☐ Rec/Store/Packaging ☐ Supplier ☐ Engineering ☐ Quality ☐ Other ☐			
Date :	Step #:	QTY Effective :		MRB (QS1042) Approval	
Description Work Order Deviation		Disposition			Completed By
					Lead hand / Supervisor Approval Verification
					QC / QA Coordinator Approval
Root Cause		FAULT CATEGORY			
Environment ☐	No Re-verification ☐	Pressure/Forced ☐	Temperature/Cure ☐	Power Loss/Surge ☐	Positioned Wrong ☐
Design ☐	Operator ☐	Bending ☐	Set-up ☐	Folio/Program ☐	Outside Dimensions ☐
Doc/Data ☐	Offset/Setup ☐	Centre Not Concentric ☐	BOM/Route ☐	Grain ☐	Over/Under tolerance ☐
Equip/Tooling ☐	Supplier ☐	Cracks ☐	Broken/Damage/Defect ☐	Weld ☐	Part Incorrect ☐
Handling/Pre ☐	Training ☐	Crimp/Kink/Ripple/Wave ☐	Inspection Incomplete/Unqualified ☐	Wrong Stock Pulled ☐	Part Lost/Missing ☐
Material ☐	Use for Testing ☐	Cuffs ☐	Contamination ☐	Out of Sequence ☐	Part Moved ☐
Internal Transport ☐	Poor Information ☐	Crushing ☐	Countersink ☐	Off-set ☐	Drawing ☐
Tribal Knowledge ☐	Rushing ☐	Heat Treat ☐	Cut Too Short ☐	Mislabeled ☐	Finish ☐
LOA ☐	Product Improvement ☐	Wave/Twist in Tube ☐	Instructions Incomplete/Unclear ☐	Fit/Function ☐	Misread ☐
Substation ☐	Process Improvement ☐	Marks/Chatter ☐	Drill Holes ☐	Misaligned/off center ☐	Turning Sequence ☐
Past Expiry Date ☐	Manufacturing Process ☐	OTHER : _____			
Misidentified ☐	Past Due ☐				

Work Order ID 135090***135090***

Page 4

Tuesday, July 28, 2015 3:46:11 PM

Item ID: 646.3015

Accept

N900040100Setup Start ***NS1***

Revision ID:

Stop ***NS2***

Item Name: Blade

Start Date: 7/28/15

Start Qty: 12.00

12

Cust Item ID:

Required Date: 8/12/15

Req'd Qty: 12.00

12

Customer:

Reference:

Approvals: Process Plan: _____ Date: _____ Tooling: _____ Date: _____

Run Start ***NR1***

QC: _____ Date: _____ SPC (Y/N): _____ Date: _____

Stop ***NR2***Sequence ID/
Work Center IDOperation
DescriptionSet Up/
Run HoursTool ID Tool # Plan
CodeAccept
QtyReject
QtyReject
NumberInsp.
Stamp

170

QC14- Inspect Spray Paint

0.00

170

QC

Memo

0.00

Quality Control

12DAS
38
9-89

AUG 31 2015

180

Identify as per dwg & Stock Location: _____

0.00

180

Packaging

Memo

0.00

Packaging

IDENTIFY AS PER APICAL MPP-120 BY STAMPING P# AND REV

GA MF 15-9-1

190

QC21- Final Inspection - Work Order Release

0.00

190

QC

Memo

0.00

Quality Control

MS SEP 02 2015MF
15-09-01

DQA: _____ Date: _____

**WORK ORDER NON-CONFORMANCE / UPDATE**

QA Closed: _____ Date: _____

Work Order update only ☐

Work Order: _____ Part No. _____ NCR No. _____	DISPOSITION Rework ☐ Scrap ☐ Use-as-is ☐ Suspected Unapproved ☐	AGAINST DEPARTMENT/PROCESS Skid-tube ☐ Machining ☐ Thermoforming ☐ Large Fab ☐ Cross tube ☐ Small Fab ☐ Finishing ☐ Composite ☐ Water Jet ☐ Prod. Eng. Coord. ☐ Rec/Store/Packaging ☐ Supplier ☐ Engineering ☐ Quality ☐ Other ☐			
Date : _____	Step #: _____	QTY Effective : _____		MRB (QS1042) Approval	
Description Work Order Deviation		Disposition		Completed By	
				Lead hand / Supervisor Approval Verification	
				QC / QA Coordinator Approval	
Root Cause		FAULT CATEGORY			
Environment ☐ Design ☐ Doc/Data ☐ Equip/Tooling ☐ Handling/Pre ☐ Material ☐ Internal Transport ☐ Tribal Knowledge ☐ LOA ☐ Substation ☐ Past Expiry Date ☐ Misidentified ☐	No Re-verification ☐ Operator ☐ Offset/Setup ☐ Supplier ☐ Training ☐ Use for Testing ☐ Poor Information ☐ Rushing ☐ Product Improvement ☐ Process Improvement ☐ Manufacturing Process ☐ Past Due ☐	Pressure/Forced ☐ Bending ☐ Centre Not Concentric ☐ Cracks ☐ Crimp/Kink/Ripple/Wave ☐ Cuffs ☐ Crushing ☐ Heat Treat ☐ Wave/Twist in Tube ☐ Marks/Chatter ☐	Temperature/Cure ☐ Set-up ☐ BOM/Route ☐ Broken/Damage/Defect ☐ Inspection Incomplete/Unqualified ☐ Contamination ☐ Countersink ☐ Cut Too Short ☐ Instructions Incomplete/Unclear ☐ Drill Holes ☐	Power Loss/Surge ☐ Folio/Program ☐ Grain ☐ Weld ☐ Wrong Stock Pulled ☐ Out of Sequence ☐ Off-set ☐ Misabeled ☐ Fit/Function ☐ Misaligned/off center ☐	Positioned Wrong ☐ Outside Dimensions ☐ Over/Under tolerance ☐ Part Incorrect ☐ Part Lost/Missing ☐ Part Moved ☐ Drawing ☐ Finish ☐ Misread ☐ Turning Sequence ☐
OTHER : _____					

Picklist Print

Tuesday, July 28, 2015 3:46:16 PM

Page 1

Work Order ID: 135090

135090

Parent Item: 646.3015

646.3015

Parent Item Name: Blade

Start Date: 7/28/15

Required Date: 8/12/15

Start Qty: 12.00

Required Qty: 12.00

Comments: IPP REV:A NEW ISSUE 12/11/09 JFS VERIFY BY: JLM

Component Item ID/ Item Name	Replacement Item ID	Mfg/ Purch	Bin Item	Primary Location	Last Location	Route Seq ID	Unit of Measure	Qty on Hand	Qty per Kit	Total Qty	Qty Issued	Date Issued	Status
---------------------------------	------------------------	---------------	-------------	---------------------	------------------	-----------------	--------------------	----------------	-------------	--------------	---------------	----------------	--------

MSTEEL-A2-
B0.500X1.250

Purchased

No

100

f

133.4520

0.549

6.934737

MSTFEI -A2-B0 500X1 250

AISI A2 TOOL STEEL BAR, 0.500 X 1.250

**

6.750

DAS

20

9-89

15-08-11

Location

Loc Qty

Loc Code

MAT010

133.452

M126438

5.452

M131783

128

127494

6.750

DQA: _____ Date: _____



WORK ORDER NON-CONFORMANCE / UPDATE

QA Closed: _____ Date: _____

Work Order update only ☐

Work Order: _____ Part No. _____ NCR No. _____	DISPOSITION Rework ☐ Scrap ☐ Use-as-is ☐ Suspected Unapproved ☐	AGAINST DEPARTMENT/PROCESS Skid-tube ☐ Machining ☐ Thermoforming ☐ Large Fab ☐ Cross tube ☐ Small Fab ☐ Finishing ☐ Composite ☐ Water Jet ☐ Prod. Eng. Coord. ☐ Rec/Store/Packaging ☐ Supplier ☐ Engineering ☐ Quality ☐ Other ☐			
Date : _____	Step #: _____	QTY Effective : _____		MRB (QS1042) Approval	
Description Work Order Deviation		Disposition		Completed By	
				Lead hand / Supervisor Approval Verification	
				QC / QA Coordinator Approval	
Root Cause Environment ☐ Design ☐ Doc/Data ☐ Equip/Tooling ☐ Handling/Pre ☐ Material ☐ Internal Transport ☐ Tribal Knowledge ☐ LOA ☐ Substation ☐ Past Expiry Date ☐ Misidentified ☐ No Re-verification ☐ Operator ☐ Offset/Setup ☐ Supplier ☐ Training ☐ Use for Testing ☐ Poor Information ☐ Rushing ☐ Product Improvement ☐ Process Improvement ☐ Manufacturing Process ☐ Past Due ☐		FAULT CATEGORY Pressure/Forced ☐ Bending ☐ Centre Not Concentric ☐ Cracks ☐ Crimp/Kink/Ripple/Wave ☐ Cuffs ☐ Crushing ☐ Heat Treat ☐ Wave/Twist in Tube ☐ Marks/Chatter ☐ Temperature/Cure ☐ Set-up ☐ BOM/Route ☐ Broken/Damage/Defect ☐ Inspection Incomplete/Unqualified ☐ Contamination ☐ Countersink ☐ Cut Too Short ☐ Instructions Incomplete/Unclear ☐ Drill Holes ☐ Power Loss/Surge ☐ Folio/Program ☐ Grain ☐ Weld ☐ Wrong Stock Pulled ☐ Out of Sequence ☐ Off-set ☐ Misabeled ☐ Fit/Function ☐ Misaligned/off center ☐ Positioned Wrong ☐ Outside Dimensions ☐ Over/Under tolerance ☐ Part Incorrect ☐ Part Lost/Missing ☐ Part Moved ☐ Drawing ☐ Finish ☐ Misread ☐ Turning Sequence ☐			
OTHER : _____					

DART AEROSPACE LTD	Work Order: 135090
Description: Lower cutter assembly	Part Number: 646-3015
Inspection Dwg: 646-3000 Rev: N/C	Page 1 of 1

FIRST ARTICLE INSPECTION CHECKLIST


Drawing Dimension	Tolerance	Actual Dimension	Accept	Reject	Method of Inspection	Comments
.375	+/- .005	.374	✓		SLO2	Mic
φ.177	+0.005 /- .000	.178	✓		Gauge	PIN
.94	+/- .010	.938	✓		SLO8	Vern
.524	+/- .005	.524	✓		Height gauge	
.240	+/- .002	.242	✓		"	
R.125	+/- .005	.125	✓		Rad gauge	
45°	+/- .5°	45°	✓		Protractor	
.524	+/- .005	.524	✓		Height gauge	
.690	+/- .002	.691	✓		"	
1.250	+/- .002	1.250	✓		"	
4.684	+/- .005	4.482	✓		SLO8	
6.45	+/- .010	6.445	✓		12" Vern	
.325	+/- .005	.322	✓		SLO8	
30°	+/- .5°	30°	✓		Protractor	

Measured by: DAS 20 9-89	Audited by: B.A. DAS 08 9-89	Preliminary Approval:
Date: 15-08-11	Date: 15/08/13	Date:

Rev	Date	Change	Revised by	Approved
E	10.04.14	Added preliminary approval	KJ	


APICAL INDUSTRIES, INC.	ENGINEERING CHANGE NOTICE NO. 02195		SHEET 1 OF 4	
	DWG NO. 646.3000	REV: N/C	PREPARED BY S. HUFF	DATE: 01/05/09
	EFFECT ON DWG ☐ INC. ☒ UNINC.			
	DWG TITLE: LOWER CUTTER ASSY			
APPROVED BY: ENGR <i>[Signature]</i>		MFG <i>[Signature]</i>	QC <i>[Signature]</i>	EFF: NEXT ORDER
TRANSACTION CODES (TC): A-ADD C-CREATE R-REVISE D-DELETE		REASON: REMOVED RIVETS IN FAVOR OF ADDITIONAL SCREWS		

SHEET 1, ZONE D5, IS:

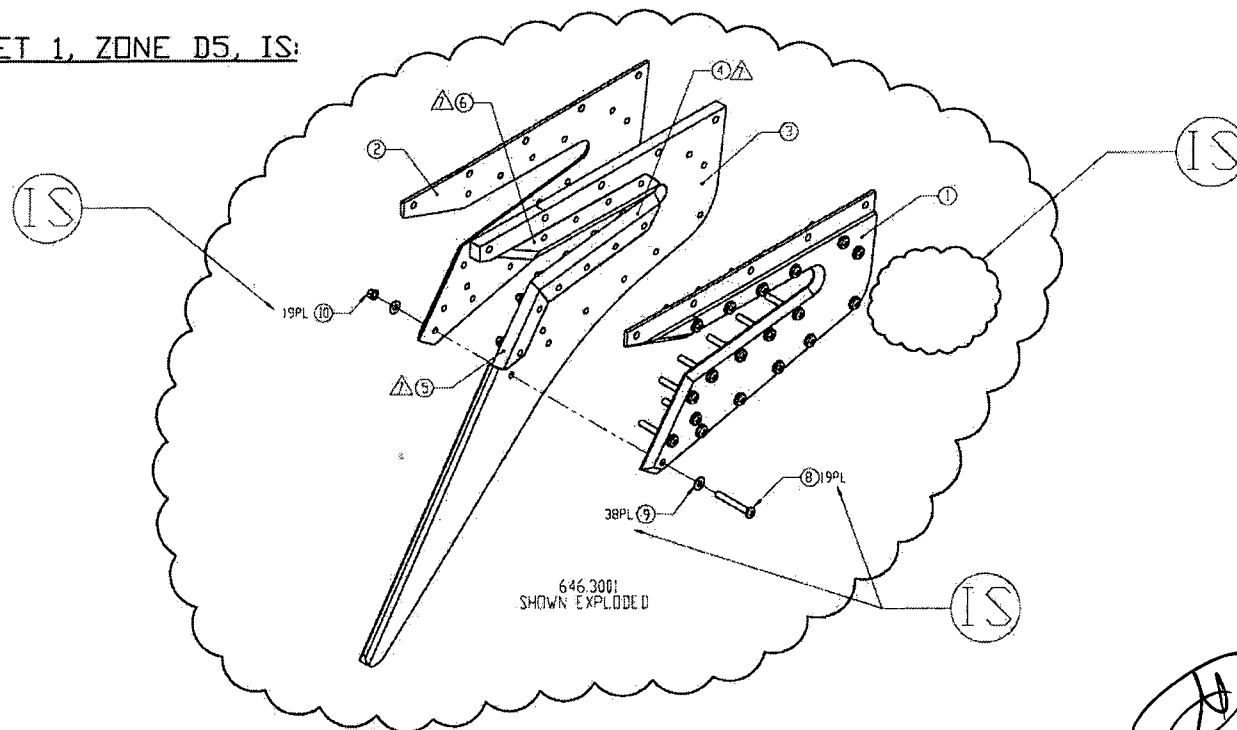


10	R	601.1541	19	LOCKNUT	MS21042L08
9	R	601.2764	38	WASHER	NAS1149FN832P
8	R	601.2765	19	SCREW	MS27039-0819
7	D	601.2766	2	RIVET	MS20470AD5-18
			.3001		
F/N	TC	PART NUMBER	QTY	DESCRIPTION	MATERIAL/SPECIFICATION
DOCUMENTS EFFECTED:					CHANGE CATEGORY
☐ MDL ☒ INSTALL INSTRUC ☒ ICA ☐ FMS ☒ BOM					DER REVIEW REQUIRED
					☐ MAJOR ☒ MINOR
					☐ YES ☒ NO

SHEET 3 IS:

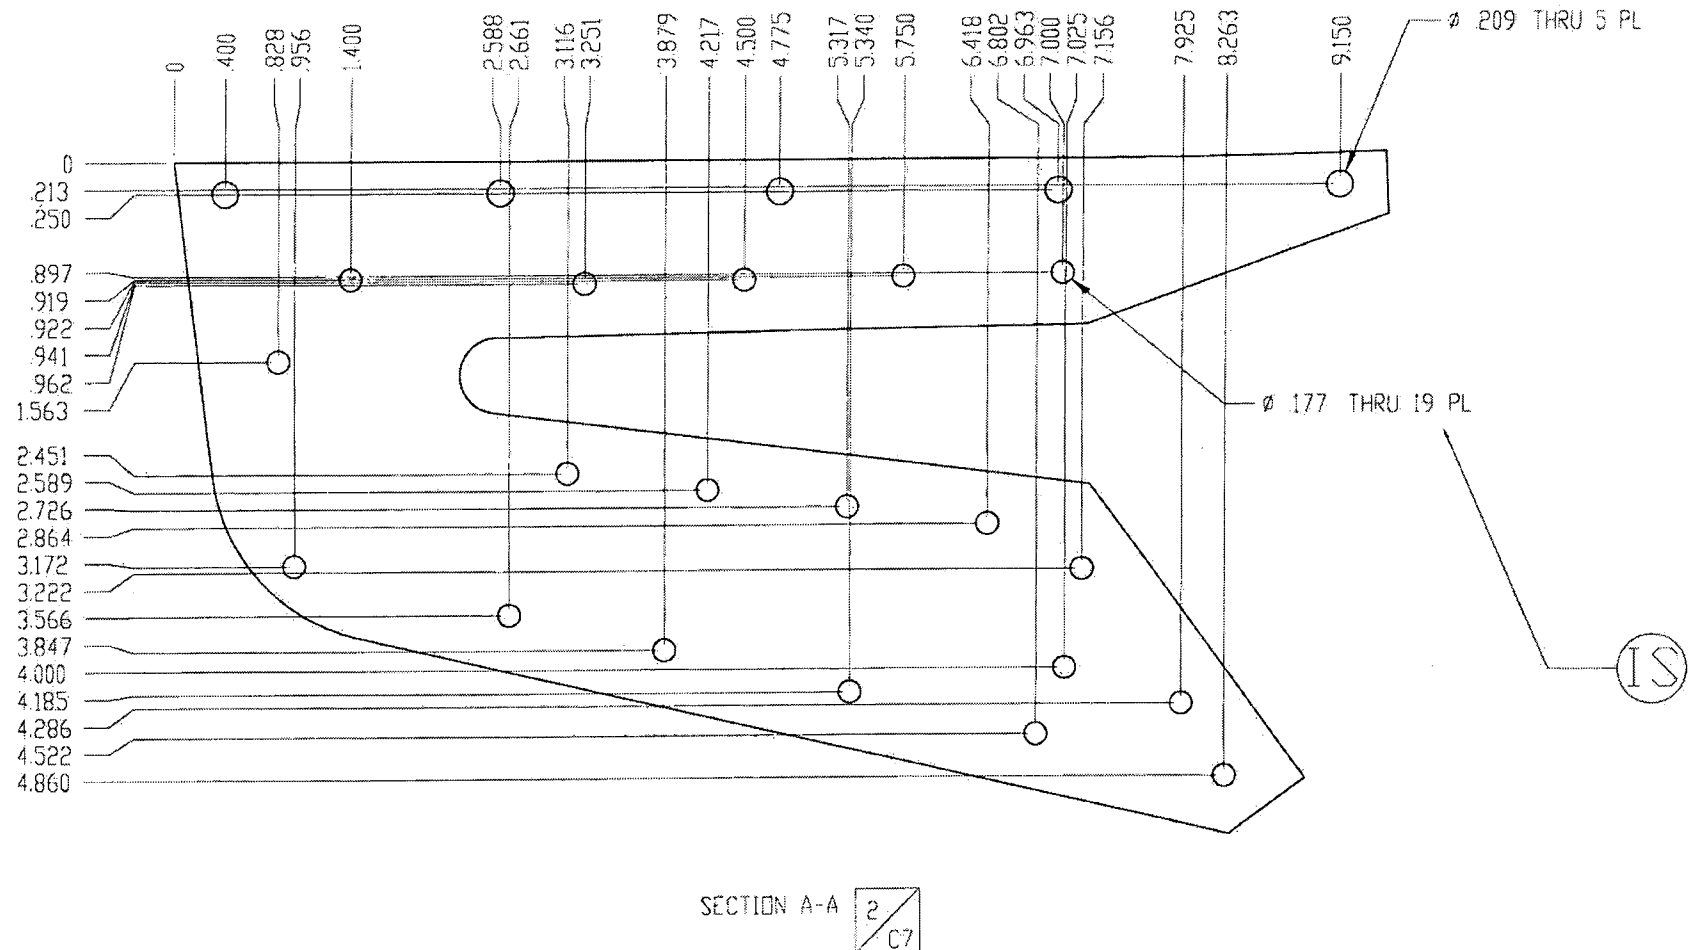

F/N	TC	PART NUMBER	QTY	DESCRIPTION	MATERIAL/SPECIFICATION

SHEET 5 IS:

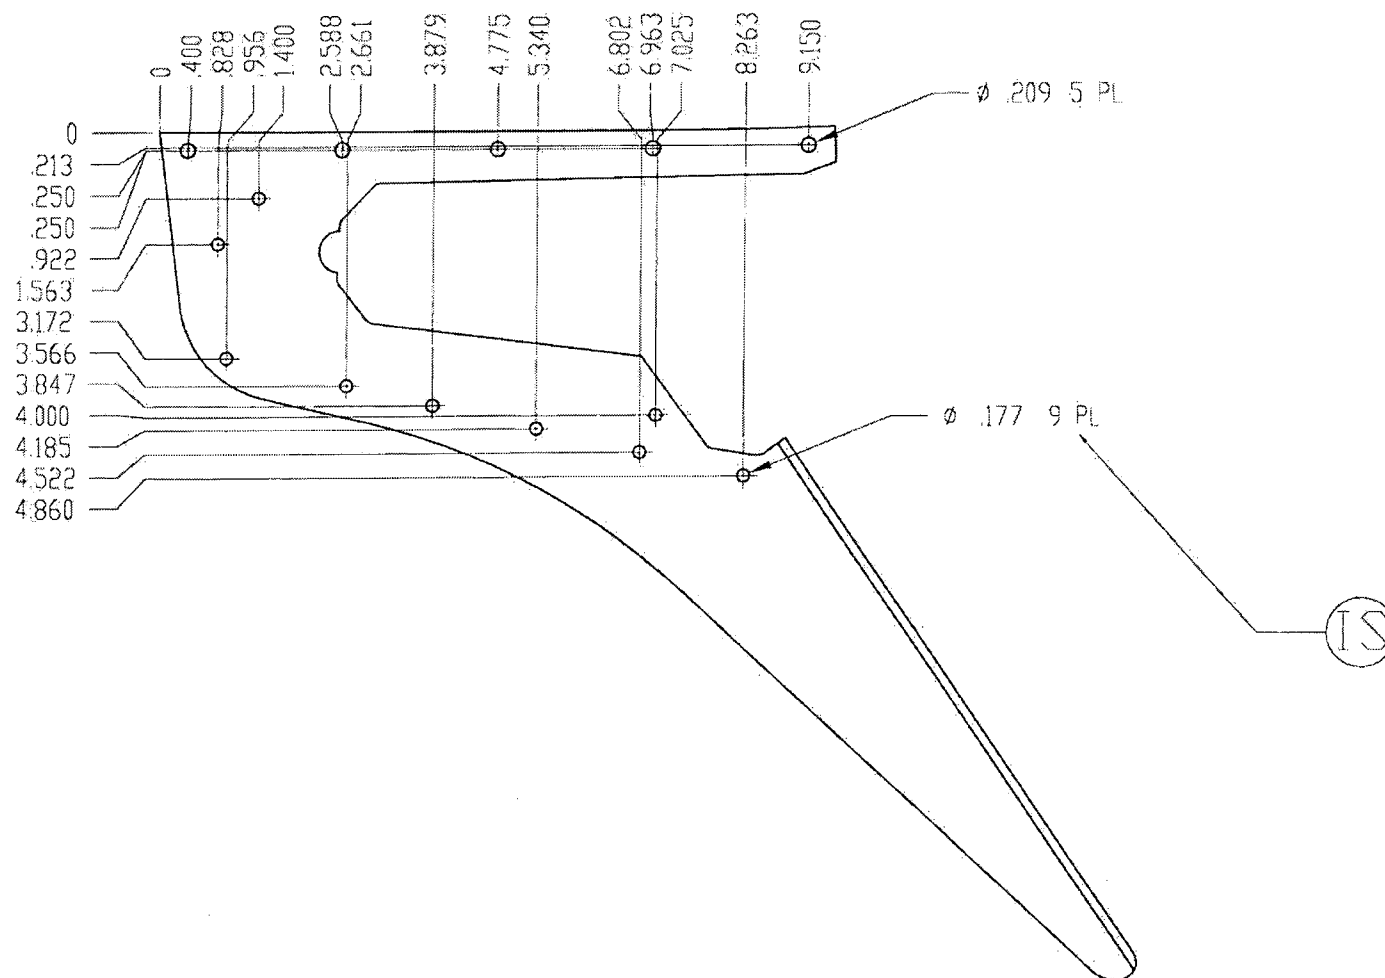


SECTION F-F

4
B6

F/N	TC	PART NUMBER	QTY	DESCRIPTION	MATERIAL/SPECIFICATION



SHEET 6, ZONE C4, IS:

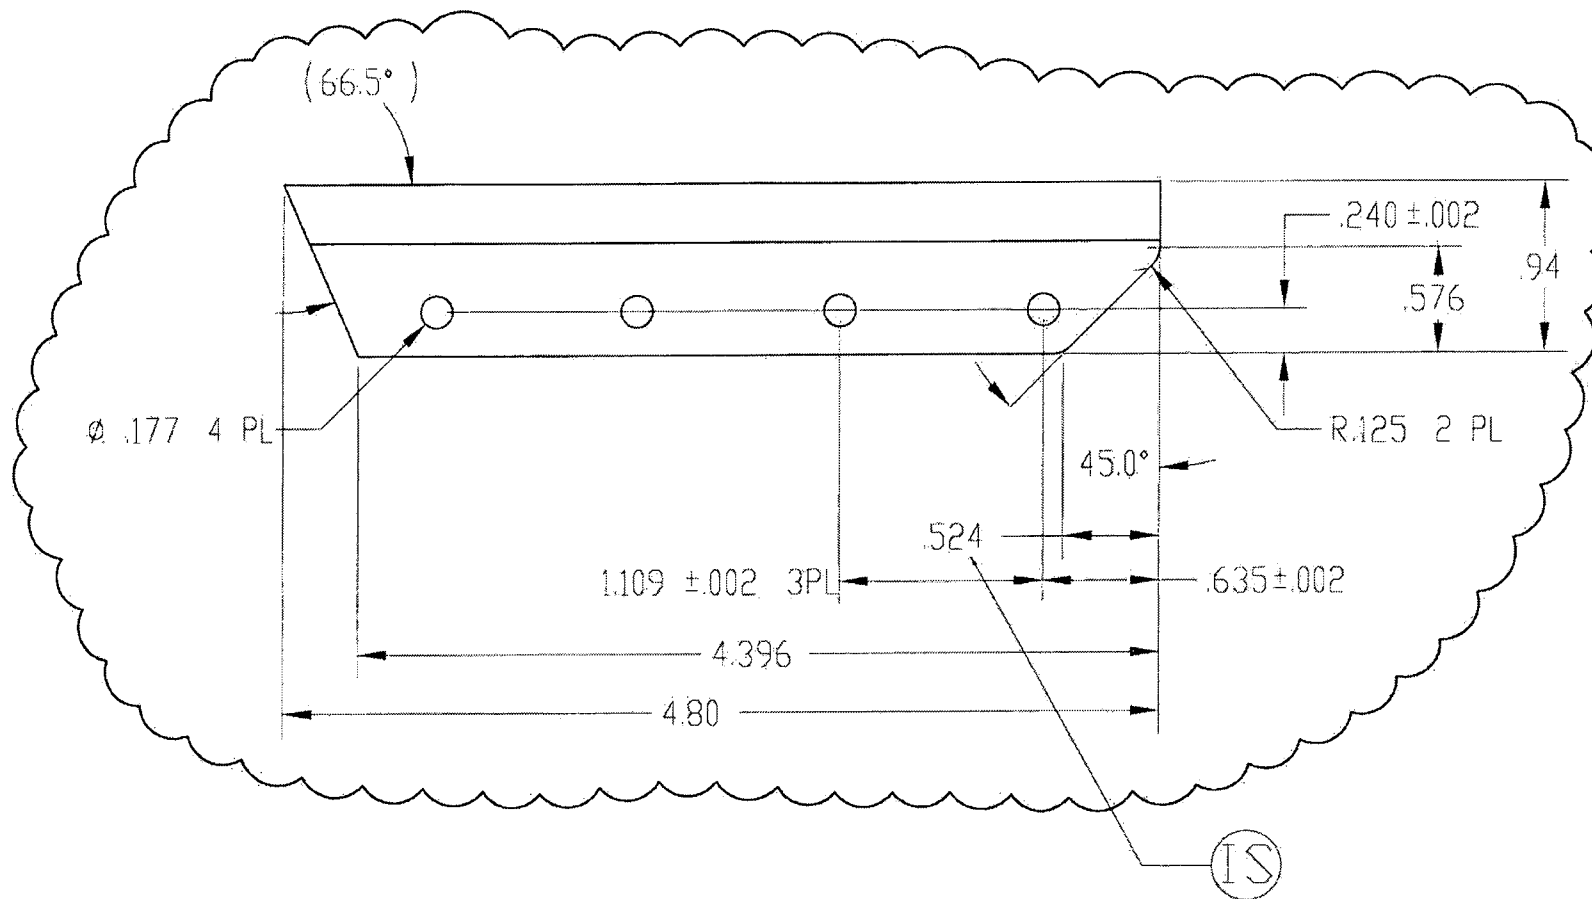



F/N	TC	PART NUMBER	QTY	DESCRIPTION	MATERIAL/SPECIFICATION
-----	----	-------------	-----	-------------	------------------------

[illegible]


THE INFORMATION CONTAINED IN THIS DRAWING IS THE SOLE PROPERTY OF APICAL INDUSTRIES. ANY REPRODUCTION IN PART OR WHOLE WITHOUT THE WRITTEN PERMISSION OF APICAL INDUSTRIES IS PROHIBITED.

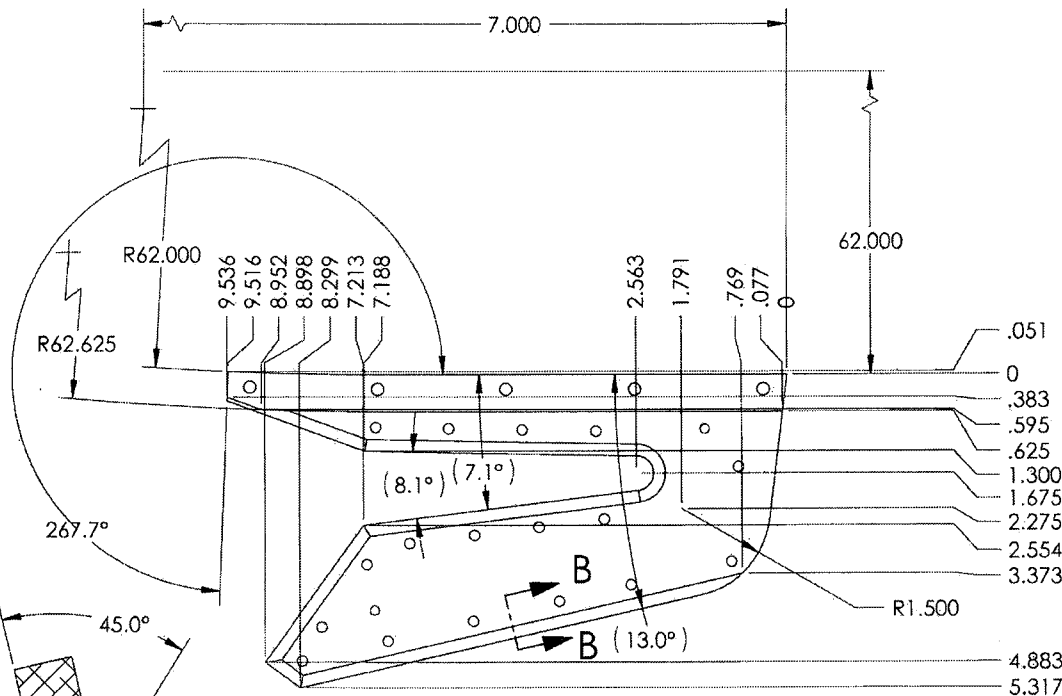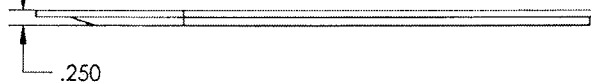

SECTION B-B
TYP EDGE DETAIL

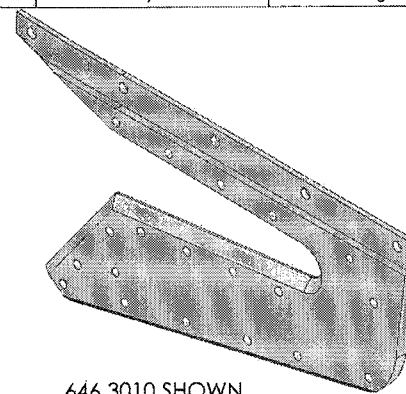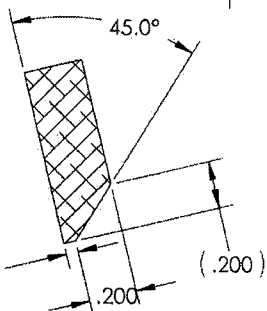


646.3010 SHOWN
646.3011 OPPOSITE

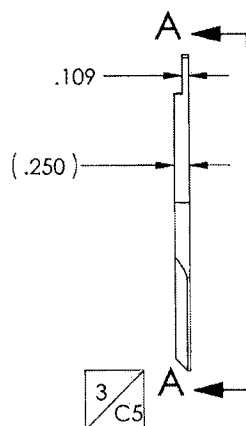

ORIGINAL DATE JUN 04 1981		APICAL INDUSTRIES	
DRAWN BY P. BRAVO		2608 TEMPLE HEIGHTS DR. OCFANSIDE, CA. 92056-3512 (760) 724-5300	
CHECKED BY J. JOSEPH		LOWER CUTTER ASSY	
CONTRACT NO.		SCALE: NONE	
UNLESS OTHERWISE SPECIFIED DIMENSIONS ARE IN INCHES TOLERANCES ARE: 3 PLACE DECIMALS ± .01 ANGLES ± .5°		SHEET 2 OF 8	REV. N/C

THE INFORMATION CONTAINED IN THIS DRAWING IS THE SOLE PROPERTY OF APICAL INDUSTRIES. ANY REPRODUCTION IN PART OR WHOLE WITHOUT THE WRITTEN PERMISSION OF APICAL INDUSTRIES IS PROHIBITED.

REVISION			
REV.	DESCRIPTION	DATE	APPROVED

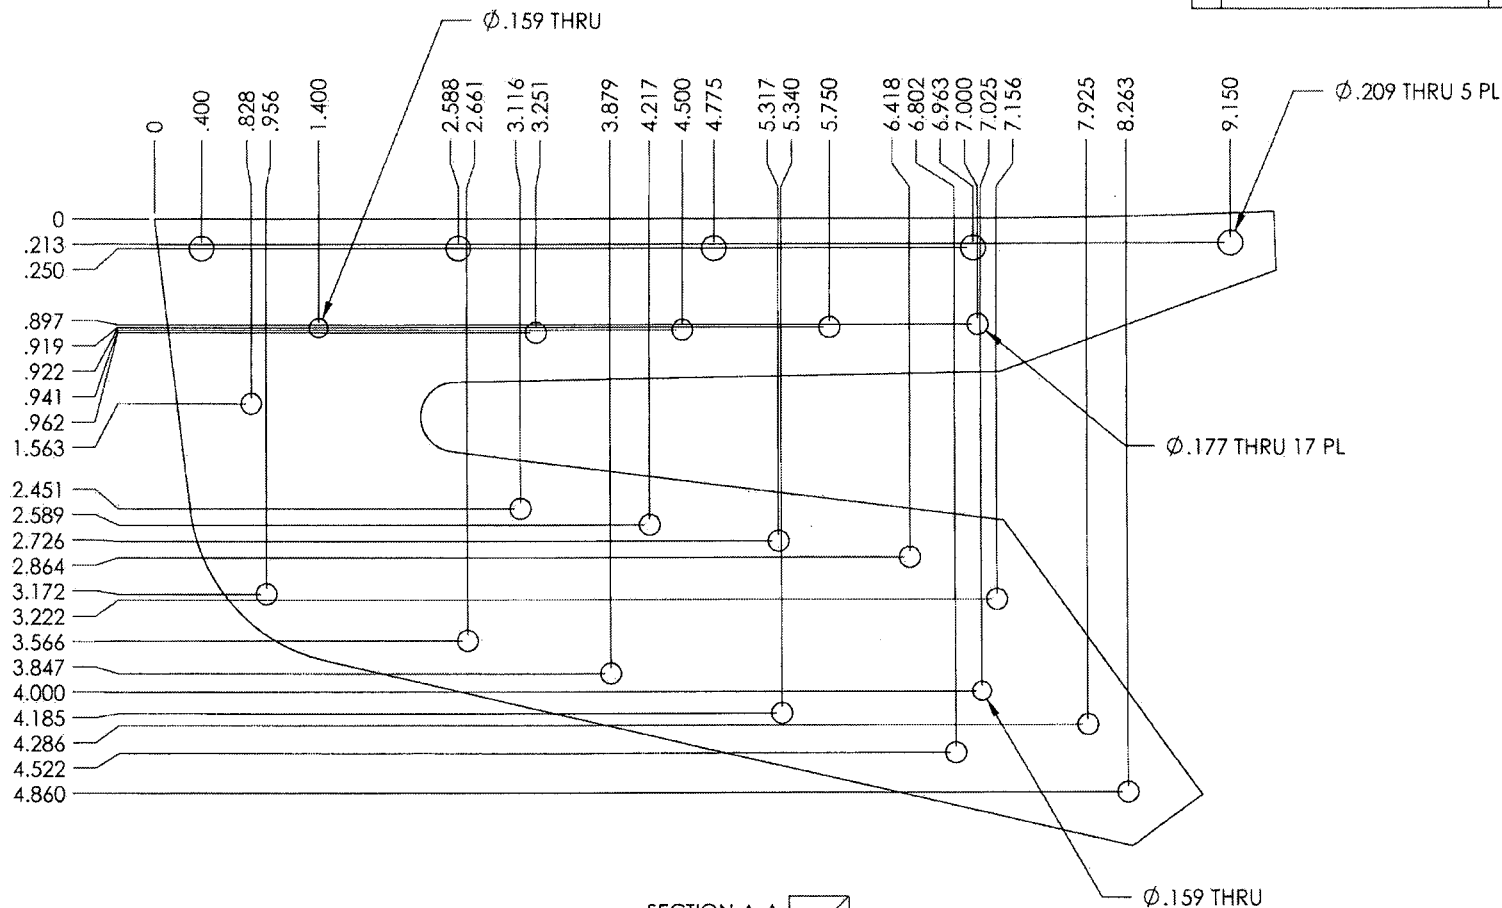


SECTION A-A 2/C7

ORIGINAL DATE 10/24/91		09/24/05	
DRAWN BY P. BRAYO	CHECKED BY J. JOSEPH	APICAL INDUSTRIES	
DRAWING APPROVAL J. JOSEPH		2608 TEMPLE HEIGHTS DR. OCEANSIDE, CA. 92056-3512 (760)724-5300	
CONTRACT NO.		LOWER CUTTER ASSY	
UNLESS OTHERWISE SPECIFIED DIMENSIONS ARE IN INCHES TOLERANCES ARE: 2 PLACE DECIMALS ±.01 3 PLACE DECIMALS ±.005 ANGLES ±.5°			
SHEET B	CAGE CODE 07M126	QTY: 100 646.3000	REV. N/C
SCALE: NONE		SHEET 3 OF 8	

THE INFORMATION CONTAINED IN THIS DRAWING IS THE SOLE PROPERTY OF
APICAL INDUSTRIES ANY REPRODUCTION IN PART OR WHOLE WITHOUT
THE WRITTEN PERMISSION OF APICAL INDUSTRIES IS PROHIBITED.

REVISIONS			
REV	DISCUSSION	DATE	APPROVE

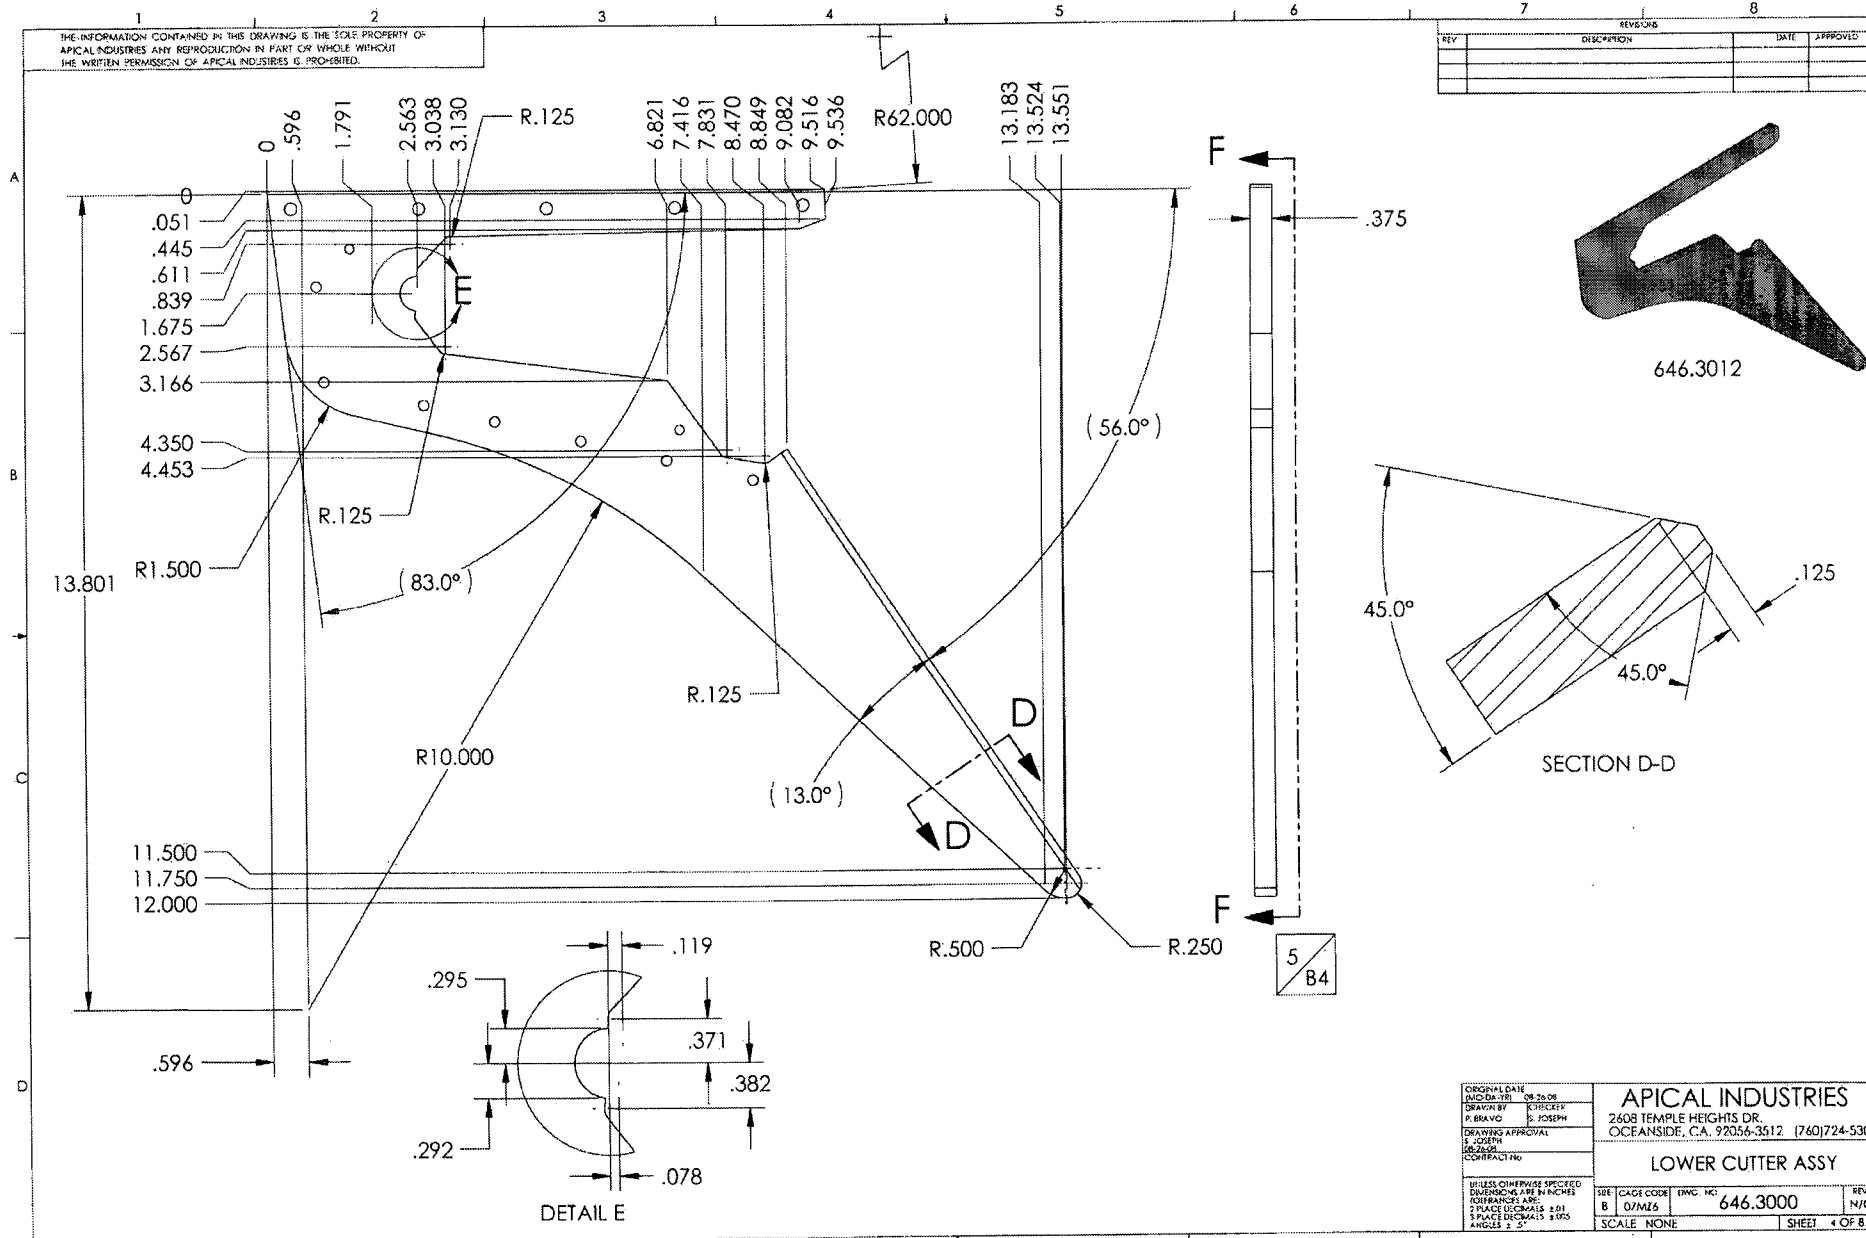

ORIGINAL DATE (MO-DA-YR)	08-26-08
DRAWN BY P. BRAVO	CHECKER S. JOSEPH
DRAWING APPROVAL S. JOSEPH 08-26-08	
CONTRACT NO.	

APICAL INDUSTRIES
2608 TEMPLE HEIGHTS DR.
OCEANSIDE, CA. 92056-3512 (760) 724-5300


LOWER CUTTER ASSY

UNLESS OTHERWISE SPECIFIED
DIMENSIONS ARE IN INCHES
(TOLERANCES ARE:
2 PLACE DECIMALS ± 0.01
3 PLACE DECIMALS ± 0.005
ANGLES $\pm 5^\circ$)

SIRE	CAGE CODE	INWG. NO.	REV.
B	07M26	646.3000	N/C
SCALE NONE		SHEET 4 OF 8	

THE INFORMATION CONTAINED IN THIS DRAWING IS THE SOLE PROPERTY OF APICAL INDUSTRIES. ANY REPRODUCTION IN PART OR WHOLE WITHOUT THE WRITTEN PERMISSION OF APICAL INDUSTRIES IS PROHIBITED.

REVISION			
REV.	DESCRIPTION	DATE	APPROVED




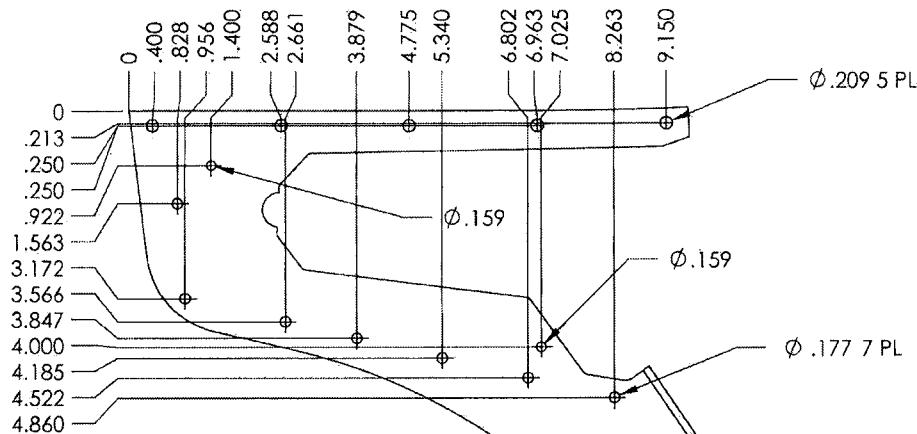


SECTION F-F 4
B6

ORIGINAL DATE IND. DATE 09-26-00		APICAL INDUSTRIES	
DRAWN BY P. BRAVO		2608 TEMPLE HEIGHTS DR. OCEANSIDE, CA. 92056-3512 (760) 724-5300	
CHECKED BY S. JOHNSON		LOWER CUTTER ASSY	
DRAWING APPROVAL S. JOHNSON		SCALE NONE	
CONTRACT NO.		SHEET 5 OF 8	
WHEN OTHERWISE SPECIFIED DIMENSIONS ARE IN INCHES TOLERANCES ARE: 2 PLACE DECIMALS $\pm .01$ 3 PLACE DECIMALS $\pm .005$ ANGLES $\pm .5^\circ$		REV. N/C	

THE INFORMATION CONTAINED IN THIS DRAWING IS THE SOLE PROPERTY OF APICAL INDUSTRIES. ANY REPRODUCTION IN PART OR WHOLE WITHOUT THE WRITTEN PERMISSION OF APICAL INDUSTRIES IS PROHIBITED.

REVISIONS			
REV	DESCRIPTION	DATE	APPROVED

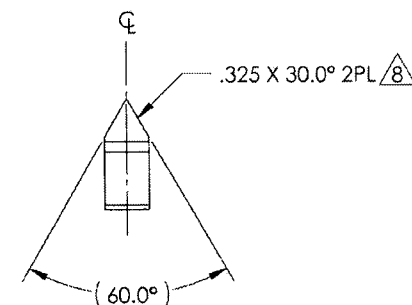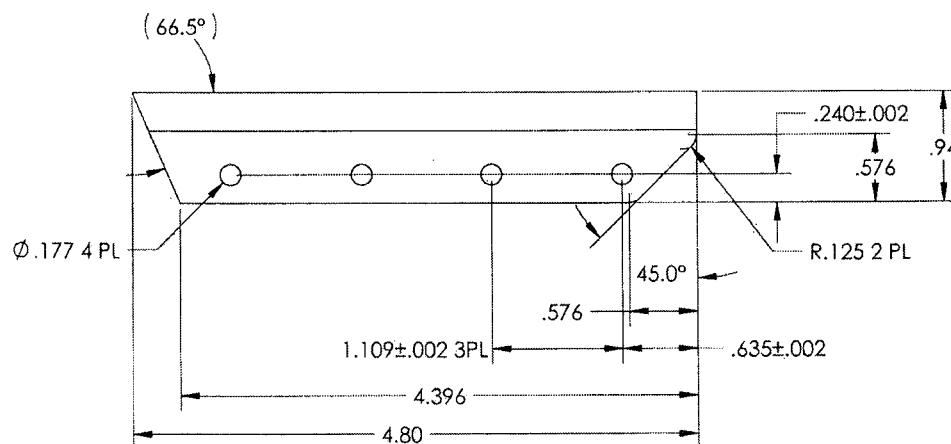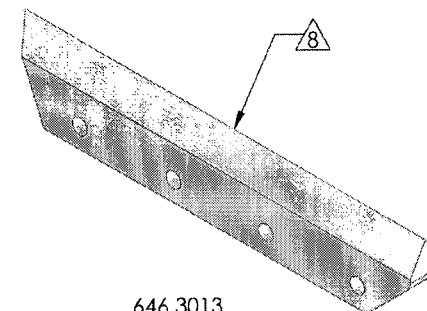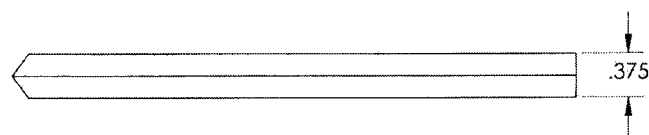

ORIGINAL DATE
 10-24-98
 DRAWN BY
 J. BRAYD
 P. BRAYD
 10-24-98
 DRAWING APPROVAL
 J. BRAYD
 10-24-98
 CONTRACT NO.

APICAL INDUSTRIES
 2608 TEMPLE HEIGHTS DR.
 OCEANSIDE, CA. 92056-3512 (760)724-5300





LOWER CUTTER ASSY

UNLESS OTHERWISE SPECIFIED
 DIMENSIONS ARE IN INCHES
 TOLERANCES ARE:
 3 PLACE DECIMALS ±.01
 ANGLES ±.5°

REV	CAGE CODE	DWG NO.	REV.
B	07M16	646.3000	11/C
SCALE NONE			SHEET 6 OF 8

THE INFORMATION CONTAINED IN THIS DRAWING IS THE SOLE PROPERTY OF APICAL INDUSTRIES. ANY REPRODUCTION IN PART OR WHOLE WITHOUT THE WRITTEN PERMISSION OF APICAL INDUSTRIES IS PROHIBITED.





REV	DESCRIPTION	DATE	APPROVED

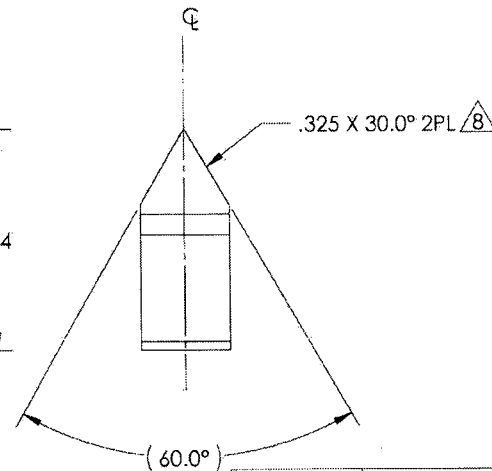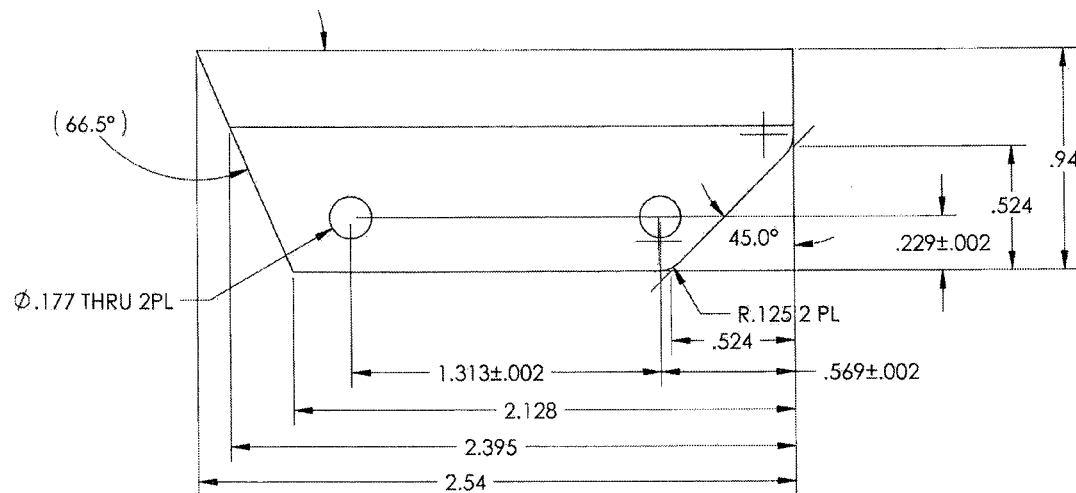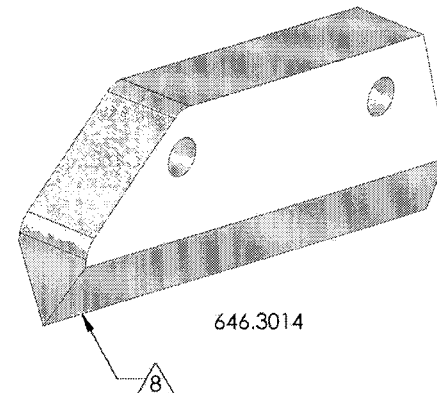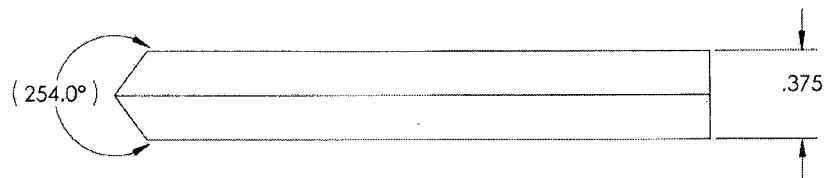

DOWNSIDE DATE (AUG-DA-10) 08-21-08 DRAWN BY J. BRAYCO DRAWING APPROVAL J. JOSEPH DOWNSIDE CONTRACT NO.		APICAL INDUSTRIES 2608 TEMPLE HEIGHTS DR. OCEANSIDE, CA. 92056-3512 (760)724-5300 LOWER CUTTER ASSY	
UNLESS OTHERWISE SPECIFIED DIMENSIONS ARE IN INCHES DECIMALS ARE 2 PLACE DECIMALS ±0.01 ANGLES ± 5°	SHEET B	CAGE CODE 07AM26	DWG. NO. 646.3000
SCALE NONE		REV. N/C SHEET 7 OF 8	

THE INFORMATION CONTAINED IN THIS DRAWING IS THE SOLE PROPERTY OF APICAL INDUSTRIES. ANY REPRODUCTION IN PART OR WHOLE WITHOUT THE WRITTEN PERMISSION OF APICAL INDUSTRIES IS PROHIBITED.

REVISIONS			
REV.	DESCRIPTION	DATE	APPROVED

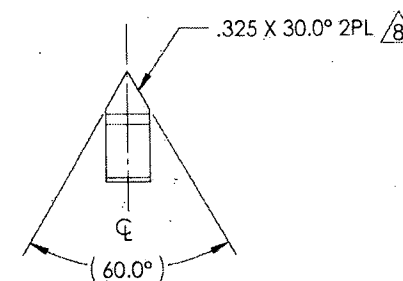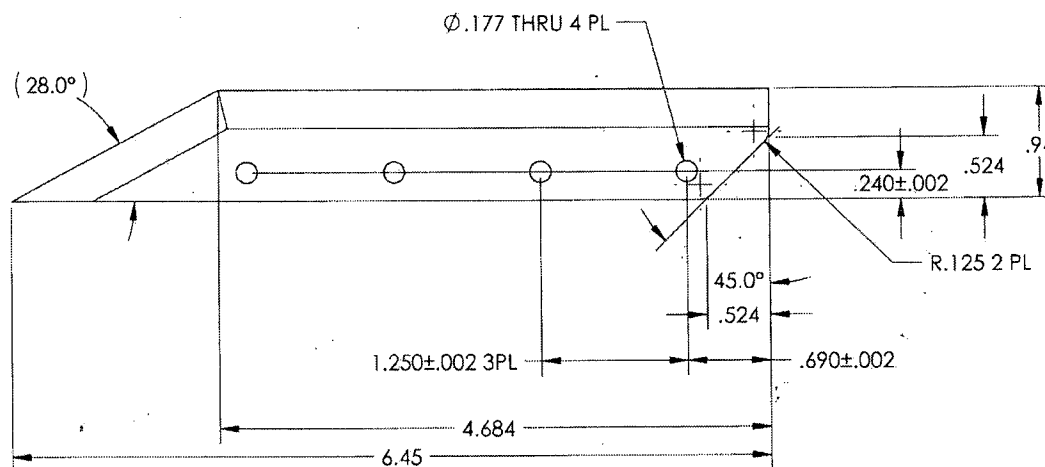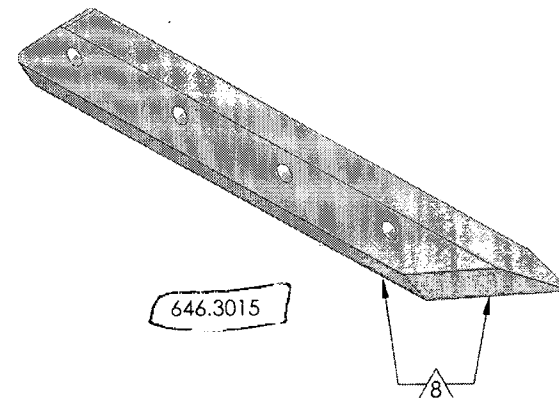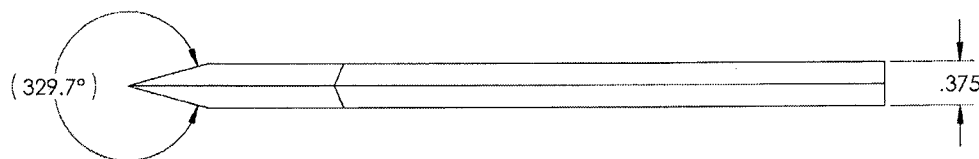

ORIGINAL DATE 08-26-08
 DRAWN BY CHICELP
 P. E. VAVO S. J. KISHIM
 DRAWING APPROVAL
 S. J. KISHIM
 CONTRACT NO.

APICAL INDUSTRIES
 2608 TEMPLE HEIGHTS DR.
 OCEANSIDE, CA 92056-3512 (760)724-5300

LOWER CUTTER ASSY

UNLESS OTHERWISE SPECIFIED
 DIMENSIONS ARE IN INCHES
 TOLERANCES ARE:
 3 PLACES DECIMALS ±.01
 2 PLACES DECIMALS ±.005
 ANGLES ±.5°

SHEET 8 OF 8
 CAGE CODE 071M26
 DOWD NO. 646.3000
 REV N/C
 SCALE NONE

METCOR INC.

560 BOUL. ARTHUR-SAUVÉ
ST-EUSTACHE, QC J7R 5A8
Tel: 450-473-1884 / Fax: 450-491-5498

Reçu de livraison

Delivery Receipt

BON DE TRAVAIL Order	EXPÉDITEUR Shipper ID	BON D'EXPÉDITION Shipper
304456	1	104612

EXPÉDITION COMPLÈTE / Shipped Complete

CLIENT / Customer 215

DART AEROSPACE
1270 ABERDEEN
HAWKESBURY, ON K6A 1K7
Ph: 613-632-5200
Fax: 613-632-1053



LIVRÉ À / Shipped To

DART AEROSPACE
1270 ABERDEEN
HAWKESBURY, ON K6A 1K7
Ph: 613-632-5200
Fax: 613-632-1053

COMMANDE DU CLIENT Customer PO	BON DE LIVRAISON DU CLIENT Customer Shipper No.	TYPE DE MATÉRIEL Material Type	DATE DE LA COMMANDE Order Date	TRANSPORTEUR Carrier
29479		A2	2015/8/19	PURO

QUANTITÉ Quantity	No. PIÈCE / Part No.	NOM DE LA PIÈCE / Part Name	DESCRIPTION DE LA PIÈCE Part Description	POIDS Weight
----------------------	-------------------------	--------------------------------	---	-----------------

12 646.3015 BLADE
(12) 646.3015 BLADE
REF. 135090

5,

1 BOITE DE CARTON

TYPE DE CONTENEUR Container Type	# DE CONTENEURS # Of Containers	COMMENTAIRES CONTENEUR Container Comments
BOITE DE CARTON	1	

certificat

EMPAQUETAGE Packing	
-------------------------------	--

QUANTITÉ EXPÉDIÉE / Quantity Shipped : 12

POIDS EXPÉDIÉ / Weight Shipped : 5,00

QUANTITÉ RESTANTE / Quantity Remaining : 0

POIDS RESTANT / Weight Remaining : 0,00

certificat

QUANTITÉ EXPÉDIÉE / Quantity Shipped : 12

POIDS EXPÉDIÉ / Weight Shipped : 5,00

Signature:

Date:

EXPÉDIÉ LE / Shipped On : 2015/08/23

METCOR INC.

560 BOUL. ARTHUR-SAUVÉ, ST-EUSTACHE, QC, J7R 5A8

Tél.: 450-473-1884

Télécopieur / Fax administration: 450-491-5498

Télécopieur / Fax production: 450 491-6454

Certificat de Conformité Détaillé

Detailed Certificate of Compliance

BON DE TRAVAIL order	CHARGEMENT load
304456	1

CLIENT / customer 215

DART AEROSPACE

1270 ABERDEEN

HAWKESBURY

ON K6A 1K7

LIVRÉ À / shipped to:

DART AEROSPACE

1270 ABERDEEN

HAWKESBURY

ON K6A 1K7

1

COMMANDE DU CLIENT customer po	BON DE LIVRAISON DU CLIENT customer shipper no.	MATÉRIEL material	MAÎTRE D'OEUVRE prime contractor	PROGRAM
29479		A2		
<u>SPÉCIFICATIONS DU PROCÉDÉ</u> processing specifications				
VAC HARDEN				
HARDEN AND TEMPER				
EXIGENCE / requirement SPÉCIFICATIONS / specified TESTS EXÉCUTÉS / performed RÉSULTATS DE TESTS / results				
HARDNESS		58 - 62 HRC	5	60 - 61 HRC
QUANTITÉ quantity	POIDS weight	DESCRIPTION DES PIÈCES parts description		
12	5	646.3015 BLADE (12) 646.3015 BLADE REF. 135090		
		1 BOITE DE CARTON		

COMMENTAIRES / comments

VAC HARDEN 1800F, 1:30 HR
DOUBLE TEMPER 400F, 2 HRS

Heat treatment (HT) was performed with equipment that meets the requirements of requested specification. All HT operations were performed in compliance with the required HT specification and all verifications have been performed and documented. No unauthorized changes were performed in regards to the HT. We certify that the material was manufactured, sampled, tested and inspected in accordance with the material specification and the purchase order and was found to meet the requirements.

Le traitement thermique (TT) a été fait en utilisant des équipements en conformité avec la spécification demandée. Toutes les opérations de TT ont été faites en conformité avec les requis de la spécification demandée et toutes les vérifications et les tests demandés ont été faites et documentés. Aucun changement n'a été faite par rapport au TT. On certifie que le matériel a été fabriqué, échantillonné, testé et inspecté en accord avec les spécifications du matériel et le bon de commande et le matériel rencontre les exigences spécifiées.

APPROUVÉ par / Approved by:

Isabel Otero
Isabel Otero
QA Technician



DATE: 2015-08-25

METCOR INC.

500 BOUL. ARTHUR-SAUVÉ, ST-EUSTACHE, QC, J7R 5A8

Tél.: 450-473-1884

Télécopieur / Fax administration: 450-491-5498

Télécopieur / Fax production: 450 491-6454

Rapport d'Inspection**Inspection Report**

BON DE TRAVAIL order	CHARGEMENT load
304456	1

CLIENT / customer 215

DART AEROSPACE

1270 ABERDEEN

HAWKESBURY

ON K8A 1K7

LIVRÉ À / shipped to:

DART AEROSPACE

1270 ABERDEEN

HAWKESBURY

ON K8A 1K7

COMMANDE DU CLIENT customer po	BON DE LIVRAISON DU CLIENT customer shipper no.	MATÉRIEL material	MAÎTRE D'OEUVRE prime contractor	PROGRAM
29479		A2		

SPÉCIFICATIONS DU PROCÉDÉ

processing specifications

VAC HARDEN

HARDEN AND TEMPER


EXIGENCE / requirement	SPÉCIFICATIONS / specified	TESTS EXÉCUTÉS / performed	RÉSULTATS DE TESTS / results
HARDNESS	58 - 62 HRC	5	60 - 61 HRC

QUANTITÉ quantity	POIDS weight	DESCRIPTION DES PIÈCES parts description
12	5	848.3015 BLADE (12) 848.3015 BLADE REF. 135090 1 BOITE DE CARTON

COMMENTAIRES / comments

26/08/2015

APPROUVÉ par / Approved by:

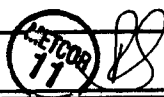

DATE: 2015-08-22



Dart Aerospace Ltd.
1270 Aberdeen Street
Hawkesbury, ON K6A 1K7
Tel: 613 632 9577
Fax: 613 632 1053

PURCHASE ORDER

Purchase Order ID PO29479

Purchase Order Date 8/17/2015

PO Print Date 8/17/2015

Page Number 1 of 2

Order From :

VC-MET004

METCOR INC.
560 BOUL. ARTHUR SAUVE
SAINT-EUSTACHE, QC J7R 5A8
CA

Ship To : DART AEROSPACE LTD

1270 ABERDEEN
HAWKESBURY, ON K6A 1K7
CANADA

FAXED

Contact Name

Vendor Phone 450 473 1884

Ship To Contact

Ship To Phone

Ship Via: FedEx Overnight collect

Ship Acct:

Buyer

Chantal Lavoie

Customer POID

Customer Tax # 10127-2607

Terms

Net 30

Currency

CAD

FOB

FCA - (Free Carrier)

Line Nbr	Reference Vendor Part Number Line Comments Delivery Comments	Description/ Mfg ID	Req Date/ Taxable Promise Date	CD	Req Qty/ Unit of Measure	PO Unit Price	Extended Price
1	135090	646.3015 BLADE	8/31/2015 Yes 8/31/2015		12.00	\$0.00	\$0.00
FINISH: HEAT TREAT TO 58-62 RC ROCKWELL HARDNESS PART ARE MADE FROM AISI A2 TOOL STEEL PLEASE NOTE: DETAIL C OF C REQUIRED							
Line Total:							\$0.00
2	71401-45	PROCUREMENT QUALITY CLAUSES	8/31/2015 No 8/31/2015		1.00 15/88/28 SO	\$0.00	\$0.00
Procurement Quality Clauses A005 right of entry A012 chemical and physical test report A020 non-destructive test/inspection identification A021 dart aerospace processing A024 process certifications A026 certification of material conformance							

Note:

8/17/2015



Dart Aerospace Ltd.
1270 Aberdeen Street
Hawkesbury, ON K6A 1K7
Tel: 613 632 9577
Fax: 613 632 1053

PURCHASE ORDER

Purchase Order ID **PO29479**

Purchase Order Date 8/17/2015

PO Print Date 8/17/2015

Page Number 2 of 2

Order From :

VC-MET004

METCOR INC.
560 BOUL. ARTHUR SAUVE
SAINT-EUSTACHE, QC J7R 5A8
CA

Ship To : DART AEROSPACE LTD

1270 ABERDEEN
HAWKESBURY, ON K6A 1K7
CANADA

Contact Name

Vendor Phone 450 473 1884

Ship To Contact

Ship To Phone

Ship Via: FedEx Overnight collect

Ship Acct:

Buyer

Chantal Lavoie

Customer POID

Customer Tax # 10127-2607

Terms

Net 30

Currency

CAD

FOB

FCA - (Free Carrier)

Line Total: \$0.00

PO Total: \$0.00

Note: Terms & Condition of Purchasing(Suppliers) and Procurement Quality Clauses are an integral part of our AS9100 requirements. To learn in detail, please visit www.dartaerospace.com for further explanation.

Change Nbr: 1

Change Date: 8/17/2015